

BISSELL
 Professional Group
 5000 S. University
 P.O. Box 1088
 Cary, NC 27513
 (919) 261-2661
 FAX (919) 261-1760

ROADWAY CONSTRUCTION & DRAINAGE PLAN

THIS DOCUMENT IS THE SOLE PROPERTY OF BISSSEL, INC. OF KENNESAW, NORTH CAROLINA. THE REPRODUCTION, IN WHOLE OR IN PART, OR THE MODIFICATION OF ANY DATA OR DESIGN IS NOT TO BE MADE WITHOUT THE WRITTEN PERMISSION OF BISSSEL, INC. COPYRIGHT 2005.


WATERLEIGH - PHASE 6
 NORTH CAROLINA
 CURRITUCK COUNTY
 MOYOCK

CONSTRUCTION RECORD DRAWINGS

NO.	DATE	REVISIONS	BY

PRELIMINARY PLAT
 For Review Purposes Only

DATE: 10-26-23 SCALE: 1"=60'
 DESIGNED: MDB
 DRAWN: AKM APPROVED: BPG
 SHEET: 3 OF 8
 CAD FILE: 457800PH6ASB
 PROJECT NO: 4578

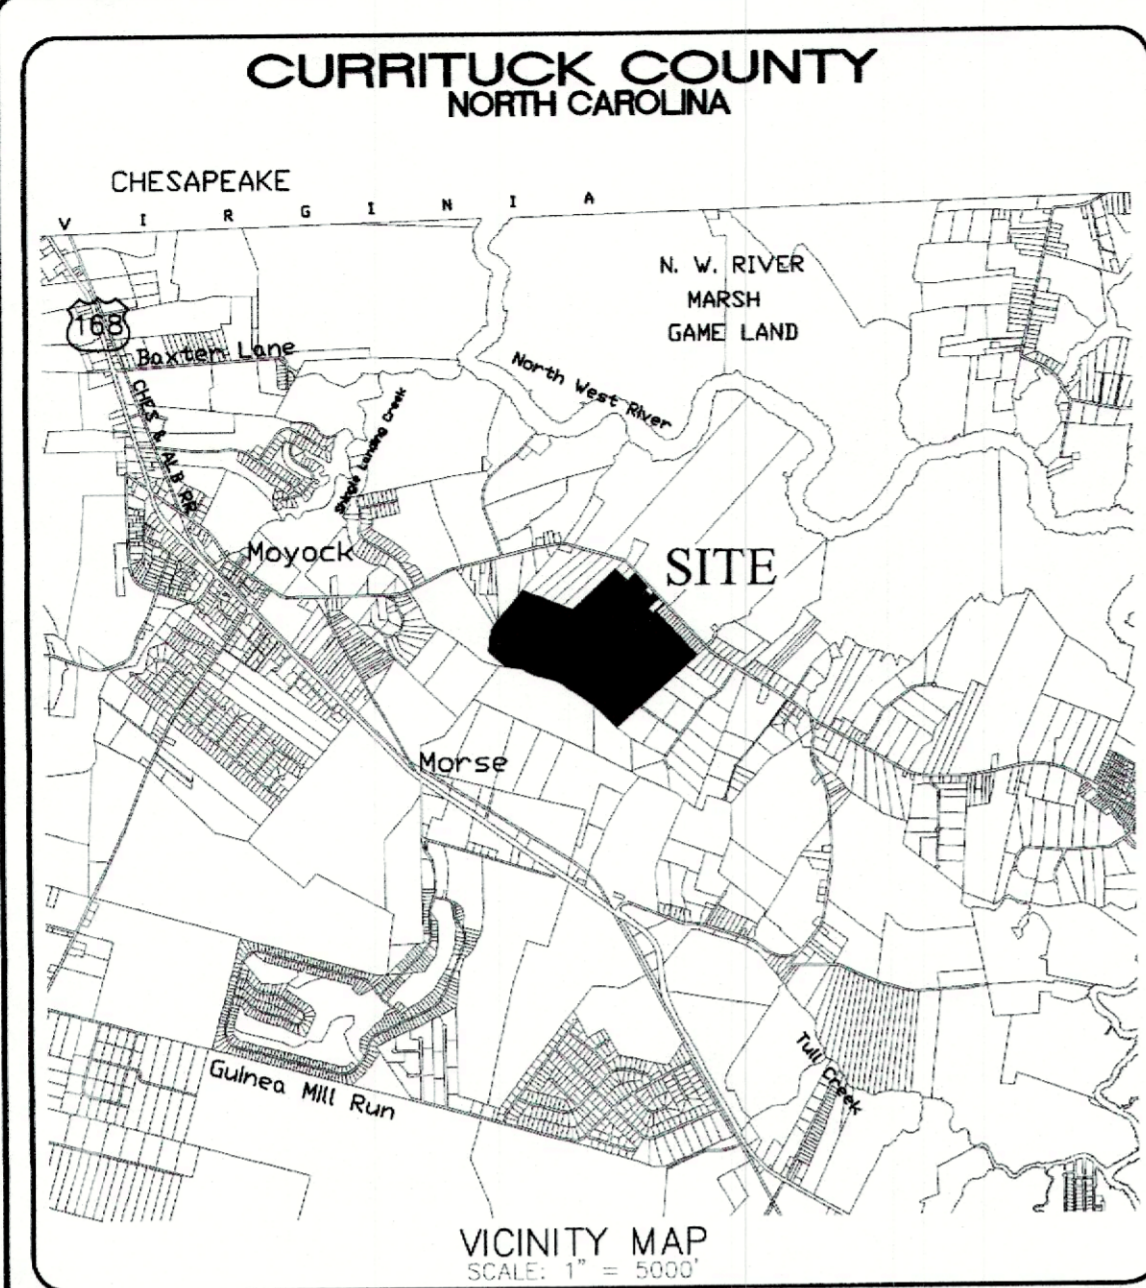

WATERLEIGH

CONSERVATION SUBDIVISION PHASE 6

MOYOCK TOWNSHIP CURRITUCK COUNTY NORTH CAROLINA



- GENERAL NOTES:**
- PROJECT NAME: WATERLEIGH
 - APPLICANT: ALLIED PROPERTIES, LLC
OWNER: ALLIED PROPERTIES, LLC
 - PROPERTY DATA:
PARCEL ID NOS.: 0014-000-039A-0000
PRIMARY ADDRESS: MOORLAND WAY
MOYOCK, NC
 - RECORDED REFERENCES: D.B. 1419, PG. 882; P.C. P, SL. 31; P.C. P, SL. 170; PC R, SL. 295; PC S, SL. 20; PC S, SL. 35-40
 - PROPERTY ZONING: SFM
 - VERTICAL DATUM IS NAVD 88.
 - F.I.R.M. DATA:
ALL LANDS SHOWN HEREON LIE IN F.E.M.A. F.I.R.M. ZONE X, PER F.E.M.A. F.I.R.M. MAP PANEL NOS. 3721803200 K, 3721804200 K, 3721804000 K, & 3721803100 K, ALL HAVING AN EFFECTIVE DATE DECEMBER 21, 2018. USE OF LAND WITHIN A FLOODWAY OR FLOOD PLAIN IS SUBSTANTIALLY RESTRICTED BY CHAPTER 7 OF THE CURRITUCK COUNTY UNIFIED DEVELOPMENT ORDINANCE.
 - THIS PROPERTY CONTAINS USACOE "404" JURISDICTIONAL WETLANDS AS SHOWN AND CONFIRMED BY USACOE ACTION ID# SAW 2016-00684, DATED JUNE 10, 2016 AND MAY REQUIRE U.S. CORP OF ENGINEERS APPROVAL PRIOR TO DEVELOPMENT OF THE PROPERTY.
 - A 10' EASEMENT FOR UTILITIES AND DRAINAGE ALONG ALL REAR AND SIDE PROPERTY LINES AND A 15' EASEMENT FOR UTILITIES AND DRAINAGE ALONG ALL FRONT PROPERTY LINES IS HEREBY ESTABLISHED. A STORMWATER MAINTENANCE EASEMENT IS HEREBY ESTABLISHED ACROSS ALL OPEN SPACE AREAS.
 - THERE IS A 20' EASEMENT IS HEREBY ESTABLISHED ALONG ALL FRONT PROPERTY LINES FOR THE PLANTING AND MAINTENANCE OF STREET TREES.
 - A NON-EXCLUSIVE DRAINAGE EASEMENT IS HEREBY DEDICATED ACROSS ALL OPEN SPACE AREAS FOR PURPOSES OF OPERATION AND MAINTENANCE OF STORMWATER MANAGEMENT SYSTEM.
 - A 5' (2.5' EITHER SIDE OF THE CENTERLINE) PEDESTRIAN EASEMENT IS HEREBY DEDICATED ALONG ALL CONCRETE SIDEWALKS AND WALKING TRAILS.
 - SUBDIVISION IS DESIGNED FOR SINGLE FAMILY DWELLINGS OF LESS THAN 4,800 S.F. AND NO GREATER THAN 2 STORIES.
 - THE CURRITUCK U.D.O. SUBSTANTIALLY RESTRICTS DEVELOPMENT WITHIN A 30' WETLAND BUFFER.
 - THE LANDS DESCRIBED IN D.B. 1471, PG. 688 & P.C. P, SL. 31-32 CAME INTO COMMON OWNERSHIP VIA D.B. 1471, PG. 697. THIS COMMON OWNERSHIP VOIDS THE NEED FOR THE DRAINAGE EASEMENT(S) SHOWN HEREON.

OWNERSHIP AND DEDICATION CERTIFICATE
I HEREBY CERTIFY THAT I AM THE OWNER OF THE PROPERTY DESCRIBED HEREON, WHICH PROPERTY IS LOCATED WITHIN THE SUBDIVISION REGULATION JURISDICTION OF CURRITUCK COUNTY, THAT I HEREBY FREELY ADOPT THIS PLAN OF SUBDIVISION AND DEDICATE TO PUBLIC USE ALL AREA SHOWN ON THIS PLAN AS STREETS, UTILITIES, ALLEYS, WALKS, RECREATION AND PARKS, OPEN SPACE AND EASEMENTS, EXCEPT THOSE SPECIFICALLY INDICATED AS PRIVATE AND THAT I WILL MAINTAIN ALL SUCH AREAS UNTIL THE OFFER OF DEDICATION IS ACCEPTED BY THE APPROPRIATE PUBLIC AUTHORITY OR HOME OWNERS' ASSOCIATION. ALL PROPERTY SHOWN ON THIS PLAN AS DEDICATED FOR A PUBLIC USE SHALL BE DEEMED TO BE DEDICATED FOR ANY OTHER PUBLIC USE AUTHORIZED BY LAW WHEN SUCH USE IS APPROVED BY THE APPROPRIATE PUBLIC AUTHORITY IN THE PUBLIC INTEREST.

DATE _____
OWNER _____
I, _____, A NOTARY PUBLIC OF _____ COUNTY, NORTH CAROLINA,
DO HEREBY CERTIFY THAT _____ PERSONALLY APPEARED BEFORE ME THIS DATE AND ACKNOWLEDGED THE DUE EXECUTION OF THE FOREGOING CERTIFICATE.
WITNESS MY HAND AND OFFICIAL SEAL THIS _____ DAY OF _____, 20 ____.

NOTARY PUBLIC MY COMMISSION EXPIRES _____

PUBLIC STREETS DIVISION OF HIGHWAY DISTRICT ENGINEER CERTIFICATE
I HEREBY CERTIFY THAT THE PUBLIC STREETS SHOWN ON THIS PLAN ARE INTENDED FOR DEDICATION AND HAVE BEEN DESIGNED OR COMPLETED IN ACCORDANCE WITH AT LEAST THE MINIMUM SPECIFICATIONS AND STANDARDS OF THE NC DEPARTMENT OF TRANSPORTATION FOR ACCEPTANCE OF SUBDIVISION STREETS ON THE NC HIGHWAY SYSTEM FOR MAINTENANCE.

DATE _____ DISTRICT ENGINEER _____
SURVEY AND ACCURACY CERTIFICATE
I, MICHAEL D. BARR, CERTIFY THAT THIS PLAN WAS DRAWN UNDER MY SUPERVISION FROM AN ACTUAL SURVEY MADE UNDER MY SUPERVISION (DEED AND DESCRIPTION RECORDED IN BOOKS REFERENCED); THAT THE BOUNDARIES NOT SURVEYED ARE CLEARLY INDICATED AS DRAWN FROM INFORMATION FOUND IN BOOKS REFERENCED; THAT THE RATIO OF PRECISION AS CALCULATED IS 1:10,000; THAT THIS PLAN WAS PREPARED IN ACCORDANCE WITH G.S. 47-30 AS AMENDED.
THIS IS TO CERTIFY THAT THIS SURVEY CREATES A SUBDIVISION OF LAND WITHIN THE AREA OF A COUNTY OR MUNICIPALITY THAT HAS AN ORDINANCE THAT REGULATES PARCELS OF LAND.
WITNESS MY ORIGINAL SIGNATURE, REGISTRATION NUMBER AND SEAL THIS 26th DAY OF OCTOBER, A.D., 2023.
DocuSigned by: _____ L-1756
C6DA34EC9CBF428...

REQUIRED IMPROVEMENTS CERTIFICATE
I HEREBY CERTIFY THAT ALL OF THE IMPROVEMENTS REQUIRED BY THE CURRITUCK COUNTY UNIFIED DEVELOPMENT ORDINANCE HAVE BEEN INSTALLED IN ACCORDANCE WITH THE PLANS AND SPECIFICATIONS PREPARED BY BISSELL PROFESSIONAL GROUP, AND THAT SAID IMPROVEMENTS COMPLY WITH CURRITUCK COUNTY SPECIFICATIONS, EXCEPT THAT A PERFORMANCE GUARANTEE HAS BEEN POSTED WITH CURRITUCK COUNTY GUARANTEEING THAT ALL REMAINING IMPROVEMENTS MUST BE COMPLETED BY THE 28TH DAY OF OCTOBER, 2025 ACCORDING TO THE PLANS AND SPECIFICATIONS PREPARED BY BISSELL PROFESSIONAL GROUP. REMAINING IMPROVEMENTS INCLUDE:
• PAVEMENT MARKINGS
• SIDEWALKS
• STREET TREES
• BUFFER TREES
• STREET LIGHTS

DocuSigned by: _____
REGISTERED LAND SURVEYOR/ENGINEER
C6DA34EC9CBF428...
L-1756
REGISTRATION NUMBER

DEVELOPMENT NOTES:

TOTAL TRACT AREA:	275.53 AC.
TOTAL AREA PHASE 6:	56.80 AC.
TOTAL AREA LOTS PHASE 6:	17.90 AC.
TOTAL R/W PHASE 6:	2.10 AC.
TOTAL AREA PHASES 1, 2, 3, 4, 5A	195.82 AC.
TOTAL AREA PHASES 1, 2, 3, 4, 5A, 6:	252.62 AC.
REQUIRED OPEN SPACE PHASE 1, 2, 3, 4, 5A, & 6 (40%):	101.05 AC.

CONSERVATION OPEN SPACE PROVIDED:

TOTAL SECONDARY OPEN SPACE PROVIDED PHASES 1, 2, 3, 4, & 5A :	79.10 AC.
PRIMARY OPEN SPACE PHASE 6	34.49 AC
SECONDARY OPEN SPACE PHASE 6	2.31 AC
TOTAL OPEN SPACE PHASE 6	36.80 AC
TOTAL OPEN SPACE PROVIDED PHASES 1, 2, 3, 4, 5A, & 6	115.90 AC
TOTAL LOTS PHASE 6:	38
AVERAGE LOT AREA PHASE 6:	22,633± S.F.
PROPOSED RIGHT-OF-WAY WIDTH:	40 FT.
PROPOSED PAVED ROADWAY WIDTH:	27 FT. B.O.C.-B.O.C.
LINEAR FEET OF ROADWAY PHASE 6:	2,303 L.F.±

Sheet Number	Sheet Title
1	COVER SHEET
2	OVERALL
3	LOT LAYOUT
4	LOT LAYOUT
5	LOT LAYOUT
6	LOT LAYOUT
7	NOTES & DETAILS

LEGEND

—	ROADWAY CENTERLINE
—	RIGHT-OF-WAY
—	PROPERTY BOUNDARY
—	ADJOINING PROPERTY LINE
□	EXISTING CONCRETE MONUMENT
□	SET CONCRETE MONUMENT
⊙	SET IRON ROD
○	EXISTING IRON ROD
○	EXISTING IRON PIPE
N.T.S.	NOT TO SCALE
P.C.	FLAT CABINET
D.B.	DEED BOOK
SL	SLIDE
SF	SQUARE FEET
AC	ACRES

LOT DEVELOPMENT CONFIGURATION:
LOT AREAS: VARY FROM 20,000 S.F. TO 25,330 S.F.
MINIMUM LOT WIDTH: 60 FT.
MAXIMUM LOT COVERAGE: 30% OF LOT AREA
SETBACKS:
FRONT: 20 FT.
SIDE: 10.5 FT.
REAR: 25 FT.

STORMWATER STATEMENT
NO MORE THAN 30% OF ANY LOT SHALL BE COVERED BY IMPERVIOUS STRUCTURES AND MATERIALS, INCLUDING ASPHALT, GRAVEL, CONCRETE, BRICK, STONE, SLATE, OR SIMILAR MATERIAL, NOT INCLUDING WOOD DECKING OR THE WATER SURFACE OF SWIMMING POOLS. THIS COVENANT IS INTENDED TO ENSURE COMPLIANCE WITH THE STORMWATER PERMIT NUMBER SW170915 ISSUED BY THE STATE OF NORTH CAROLINA. THE COVENANT MAY NOT BE CHANGED OR DELETED WITHOUT THE CONSENT OF THE STATE. FILLING IN OR PIPING OF ANY VEGETATIVE CONVEYANCES (DITCHES, SWALES, ETC.) ASSOCIATED WITH THIS DEVELOPMENT, EXCEPT FOR AVERAGE DRIVEWAY CROSSINGS, IS STRICTLY PROHIBITED BY ANY PERSON. THE LOT COVERAGE ALLOWANCE PROVIDED IN THE CURRITUCK COUNTY UNIFIED DEVELOPMENT ORDINANCE MAY BE DIFFERENT THAN THE NC STATE STORMWATER PERMIT. THE MOST RESTRICTIVE LOT COVERAGE SHALL APPLY.

PUBLIC DEDICATION OF RECREATION AND PARK AREA STATEMENT
A PAYMENT-IN-LIEU OF RECREATION AND PARK AREA DEDICATION HAS BEEN PROVIDED IN ACCORDANCE WITH THE CURRITUCK COUNTY UNIFIED DEVELOPMENT ORDINANCE. PAYMENTS-IN-LIEU RECEIVED BY THE COUNTY SHALL BE USED ONLY FOR THE ACQUISITION OR DEVELOPMENT OF RECREATION AND PARK AREAS, AND OPEN SPACE SITES CONSISTENT WITH THE REQUIREMENTS OF NORTH CAROLINA GENERAL STATUTES SECTION 153A-331.

PROPERTY ADJACENT TO ACTIVE FARMLAND STATEMENT
AS OF THE RECORDED DATE OF THIS PLAN, SOME PORTIONS OF THIS DEVELOPMENT ADJOIN LAND USED FOR ACTIVE AGRICULTURE PURPOSES WHICH MAY INCLUDE, BUT NOT BE LIMITED TO ACTIVITIES SUCH AS DUST GENERATION, SPRAYING OF CHEMICALS, ETC., THEREFORE, FURTHER INVESTIGATION MAY BE DESIRED BY PROSPECTIVE PURCHASERS.

INTERCONNECTIVITY STATEMENT
THIS SUBDIVISION CONTAINS A RIGHT-OF-WAY THAT IS PLATTED WITH THE INTENT OF BEING EXTENDED AND CONTINUED TO AND FROM ADJOINING PROPERTIES. ACCESS WITHIN THE RIGHT-OF-WAY FOR STREETS AND UTILITIES SHALL NOT BE RESTRICTED.

APPROVAL CERTIFICATE
I HEREBY CERTIFY THAT THE SUBDIVISION SHOWN ON THIS PLAN IS IN ALL RESPECTS IN COMPLIANCE WITH THE CURRITUCK COUNTY UNIFIED DEVELOPMENT ORDINANCE AND, THEREFORE, THIS PLAN HAS BEEN APPROVED BY THE CURRITUCK COUNTY TECHNICAL REVIEW COMMITTEE AND SIGNED BY THE ADMINISTRATOR, SUBJECT TO ITS BEING RECORDED IN THE CURRITUCK COUNTY REGISTRY WITHIN 90 DAYS OF THE DATE BELOW.

DATE _____ ADMINISTRATOR _____

REVIEW OFFICER CERTIFICATE
STATE OF NORTH CAROLINA,
COUNTY OF CURRITUCK
I, _____, REVIEW OFFICER OF CURRITUCK COUNTY, CERTIFY THAT THE MAP OR PLAN TO WHICH THIS CERTIFICATION IS AFFIXED MEETS ALL STATUTORY REQUIREMENTS FOR RECORDING.

DATE _____
REVIEW OFFICER _____

BISSELL PROFESSIONAL GROUP
Firm License # C-966
3512 North Croatan Highway
P.O. Box 1068 North Carolina 27949
(252) 261-3266
(252) 261-1760
Engineers, Planners, Surveyors
and Environmental Specialists
This document is the sole property of BPG, Inc. of Kitty Hawk, North Carolina. The use or reproduction in whole or in part without the written consent of Michael S. Bissell, Principal of BPG, Inc. Copyright 2005.

PROJECT: WATERLEIGH - PHASE 6
 COVER SHEET
 MOYOCK TOWNSHIP CURRITUCK COUNTY NORTH CAROLINA
 FINAL CONSERVATION SUBDIVISION PLAN

REVISIONS


NO.	DATE	DESCRIPTION	BY	CHKD

DATE:	08-15-23	SCALE:	AS SHOWN
DESIGNED:		CHECKED:	
DRAWN:	AKM	APPROVED:	MDB
SHEET:			BPG
1		OF 7	
CAD FILE:		457800FP6	
PROJECT NO:		4578	

WATERLEIGH
PHASE
5 - A
(P.C. S, SL. 35)



NC NAD 83(2011) GRID NORTH

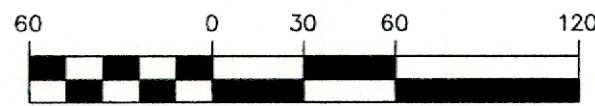

1" = 60'
GRAPHIC SCALE

BISSELL
PROFESSIONAL GROUP
Engineers, Planners, Surveyors
and Environmental Specialists

Blissell Professional Group
Firm License # C-955
3512 North Croatan Highway
P.O. Box 1068 North Carolina 27949
MOYOCK, NC
(252) 281-3266
FAX (252) 261-1760

The document is the sole property of BPG, Inc. of Kitty Hawk, North Carolina. The reader agrees to indemnify and hold BPG, Inc. harmless from and against any and all claims, damages, costs, and expenses, including reasonable attorneys' fees, that may be asserted against or incurred by BPG, Inc. in connection with this project. Copyright 2005.

PROJECT: WATERLEIGH - PHASE 6
LOT LAYOUT

MOYOCK TOWNSHIP CURRITUCK COUNTY NORTH CAROLINA

FINAL CONSERVATION SUBDIVISION PLAT

NO.	DATE	DESCRIPTION	BY
1	08-15-23	REVISIONS	MDB

DocuSigned by:
Michael Bissell
C6DA34EC9CBF428

DATE: 08-15-23 SCALE: 1" = 60'

DRAWN: AKM CHECKED: MDB

APPROVED: BPG

SHEET: 3 OF 7

CAD FILE: 457800FP6

PROJECT NO: 4578

CURVE	LENGTH	RADIUS	CHORD	BEARING	DELTA
C1	89.29'	490.00'	89.17'	N69° 09' 54"W	10°26'27"
C2	52.25'	510.00'	52.23'	S71° 27' 01"E	5°52'12"
C3	214.54'	265.00'	208.73'	S45° 19' 21"E	46°23'09"
C4	54.65'	265.00'	54.55'	N74° 09' 42"E	11°48'58"
C5	35.82'	425.00'	35.81'	N81° 26' 51"W	4°49'47"
C6	77.37'	125.00'	76.14'	S66° 07' 54"E	35°27'41"
C7	49.82'	125.00'	49.49'	N59° 49' 07"W	22°50'07"
C8	11.19'	470.00'	11.19'	N64° 37' 35"W	1°21'49"
C9	74.46'	470.00'	74.38'	N69° 50' 48"W	9°04'38"
C10	54.30'	530.00'	54.28'	S71° 27' 01"E	5°52'12"
C11	88.42'	285.00'	88.07'	S59° 37' 38"E	17°46'33"
C12	113.29'	285.00'	112.55'	S39° 21' 05"E	22°46'33"
C13	14.35'	20.00'	14.05'	N48° 31' 30"W	41°07'23"
C14	8.73'	20.00'	8.66'	N81° 35' 29"W	25°00'35"
C15	74.93'	285.00'	74.71'	S86° 33' 52"E	15°03'49"
C16	34.14'	405.00'	34.13'	N81° 26' 51"W	4°49'47"
C17	50.29'	145.00'	50.03'	S73° 55' 38"E	19°52'13"
C18	39.46'	145.00'	39.34'	S56° 11' 47"E	15°35'29"
C19	11.33'	105.00'	11.33'	N51° 29' 33"W	6°11'01"
C20	30.52'	105.00'	30.41'	N62° 54' 37"W	16°39'07"

CURVE	LENGTH	RADIUS	CHORD	BEARING	DELTA
C21	28.89'	145.00'	28.85'	N65° 31' 39"W	11°25'04"
C22	28.89'	145.00'	28.85'	N54° 06' 35"W	11°25'04"
C23	24.47'	105.00'	24.42'	S55° 04' 42"E	13°21'19"
C24	40.51'	105.00'	40.26'	S72° 48' 33"E	22°06'23"
C25	37.51'	445.00'	37.50'	N81° 26' 51"W	4°49'47"
C26	139.88'	245.00'	137.99'	N84° 36' 39"E	32°42'47"
C27	106.82'	285.00'	106.20'	N57° 30' 57"E	21°28'31"
C28	8.64'	285.00'	8.63'	N69° 06' 48"E	1°44'10"
C29	36.25'	20.00'	31.49'	S18° 03' 44"W	103°51'38"
C30	148.15'	245.00'	145.91'	S51° 11' 30"E	34°38'50"
C31	13.35'	490.00'	13.35'	S69° 17' 45"E	1°33'39"
C32	36.85'	490.00'	36.84'	S72° 13' 51"E	4°18'33"
C33	60.92'	510.00'	60.89'	N70° 57' 48"W	6°50'39"
C34	32.01'	510.00'	32.01'	N65° 44' 34"W	3°35'48"
C35	14.54'	147.65'	14.54'	S67° 45' 45"W	5°38'37"
C36	231.68'	267.84'	224.53'	N84° 38' 09"W	49°33'36"
C37	103.78'	232.08'	102.92'	N47° 02' 42"W	25°37'19"
C38	45.25'	106.82'	44.92'	S46° 22' 15"E	24°16'26"
C39	137.64'	348.63'	136.75'	S69° 49' 05"E	22°37'14"
C40	128.13'	880.14'	128.01'	N76° 57' 29"W	8°20'27"

CURVE	LENGTH	RADIUS	CHORD	BEARING	DELTA
C41	142.22'	488.59'	141.72'	N64° 26' 54"W	16°40'42"
C42	52.40'	50.40'	50.07'	N85° 53' 42"W	59°34'17"
C43	63.30'	279.54'	63.16'	N60° 36' 11"E	12°58'27"
C44	129.03'	510.11'	128.68'	S61° 21' 44"W	14°29'32"
C45	180.97'	1867.37'	180.88'	S71° 43' 03"W	6°13'07"
C46	50.57'	127.36'	50.24'	N63° 27' 09"E	22°44'55"
C47	112.81'	264.80'	111.96'	N39° 52' 24"E	24°24'35"
C48	76.07'	2044.71'	76.07'	N25° 34' 37"E	2°07'54"
C49	107.35'	234.97'	106.42'	S37° 36' 00"W	26°10'39"
C50	148.84'	365.47'	147.82'	S62° 21' 22"W	23°20'06"
C51	158.02'	204.74'	154.13'	N83° 51' 54"W	44°13'23"
C52	71.47'	207.79'	71.11'	N51° 54' 03"W	19°42'19"
C53	96.65'	265.00'	96.12'	S89° 28' 53"E	20°53'51"


LINE	LENGTH	BEARING
L1	58.37	N9° 07' 43"E
L2	84.17	N9° 07' 43"E
L3	11.71	N9° 16' 33"E
L4	126.82	N9° 15' 06"E
L5	40.52	N9° 35' 16"E
L6	249.70	N9° 49' 50"E
L7	15.59	S64° 19' 10"W

Lot 214: 306 Arbormoor Lane	Lot 234: 305 Arbormoor Lane
Lot 215: 308 Arbormoor Lane	Lot 235: 303 Arbormoor Lane
Lot 216: 310 Arbormoor Lane	Lot 236: 301 Arbormoor Lane
Lot 217: 312 Arbormoor Lane	Lot 237: 331 Moorland Way
Lot 218: 314 Arbormoor Lane	Lot 238: 329 Moorland Way
Lot 219: 316 Arbormoor Lane	Lot 239: 327 Moorland Way
Lot 220: 318 Arbormoor Lane	Lot 240: 325 Moorland Way
Lot 221: 320 Arbormoor Lane	Lot 241: 323 Moorland Way
Lot 222: 322 Arbormoor Lane	Lot 242: 321 Moorland Way
Lot 223: 324 Arbormoor Lane	Lot 243: 319 Moorland Way
Lot 224: 325 Arbormoor Lane	Lot 244: 317 Moorland Way
Lot 225: 323 Arbormoor Lane	
Lot 226: 321 Arbormoor Lane	Lot 258: 310 Moorland Way
Lot 227: 319 Arbormoor Lane	Lot 259: 312 Moorland Way
Lot 228: 317 Arbormoor Lane	Lot 260: 314 Moorland Way
Lot 229: 315 Arbormoor Lane	Lot 261: 316 Moorland Way
Lot 230: 313 Arbormoor Lane	Lot 262: 318 Moorland Way
Lot 231: 311 Arbormoor Lane	Lot 263: 320 Moorland Way
Lot 232: 309 Arbormoor Lane	Lot 264: 322 Moorland Way
Lot 233: 307 Arbormoor Lane	


LOT	WWE	BPE	FFE
214	9.30	9.90	9.90
215	9.40	10.20	10.20
216	9.40	10.20	10.20
217	9.30	9.90	9.90
218	9.10	9.70	9.70
219	8.90	9.50	9.50
220	8.90	9.50	9.50
221	9.10	9.70	9.70
222	9.20	9.90	9.90
223	8.90	9.80	9.80
224	8.60	9.60	9.60
225	8.80	9.40	9.40
226	9.00	9.70	9.70
227	9.20	9.70	9.70
228	9.40	10.10	10.10
229	9.50	10.20	10.20

LOT	WWE	BPE	FFE
230	9.50	10.20	10.20
231	9.40	10.10	10.10
232	9.20	9.90	9.90
233	9.00	9.70	9.70
234	9.00	9.80	9.80
235	9.00	9.80	9.80
236	9.00	10.00	10.00
237	9.60	10.20	10.20
238	9.70	10.40	10.40
239	9.50	10.40	10.40
240	9.50	10.10	10.10
241	9.30	9.90	9.90
242	9.00	9.70	9.70
243	9.10	9.70	9.70
244	9.20	9.90	9.90

LOT	WWE	BPE	FFE
258	9.30	9.90	9.90
259	9.30	9.80	9.80
260	9.40	9.80	9.80
261	9.60	10.10	10.10
262	9.80	10.20	10.20
263	9.90	10.40	10.40
264	9.90	10.40	10.40

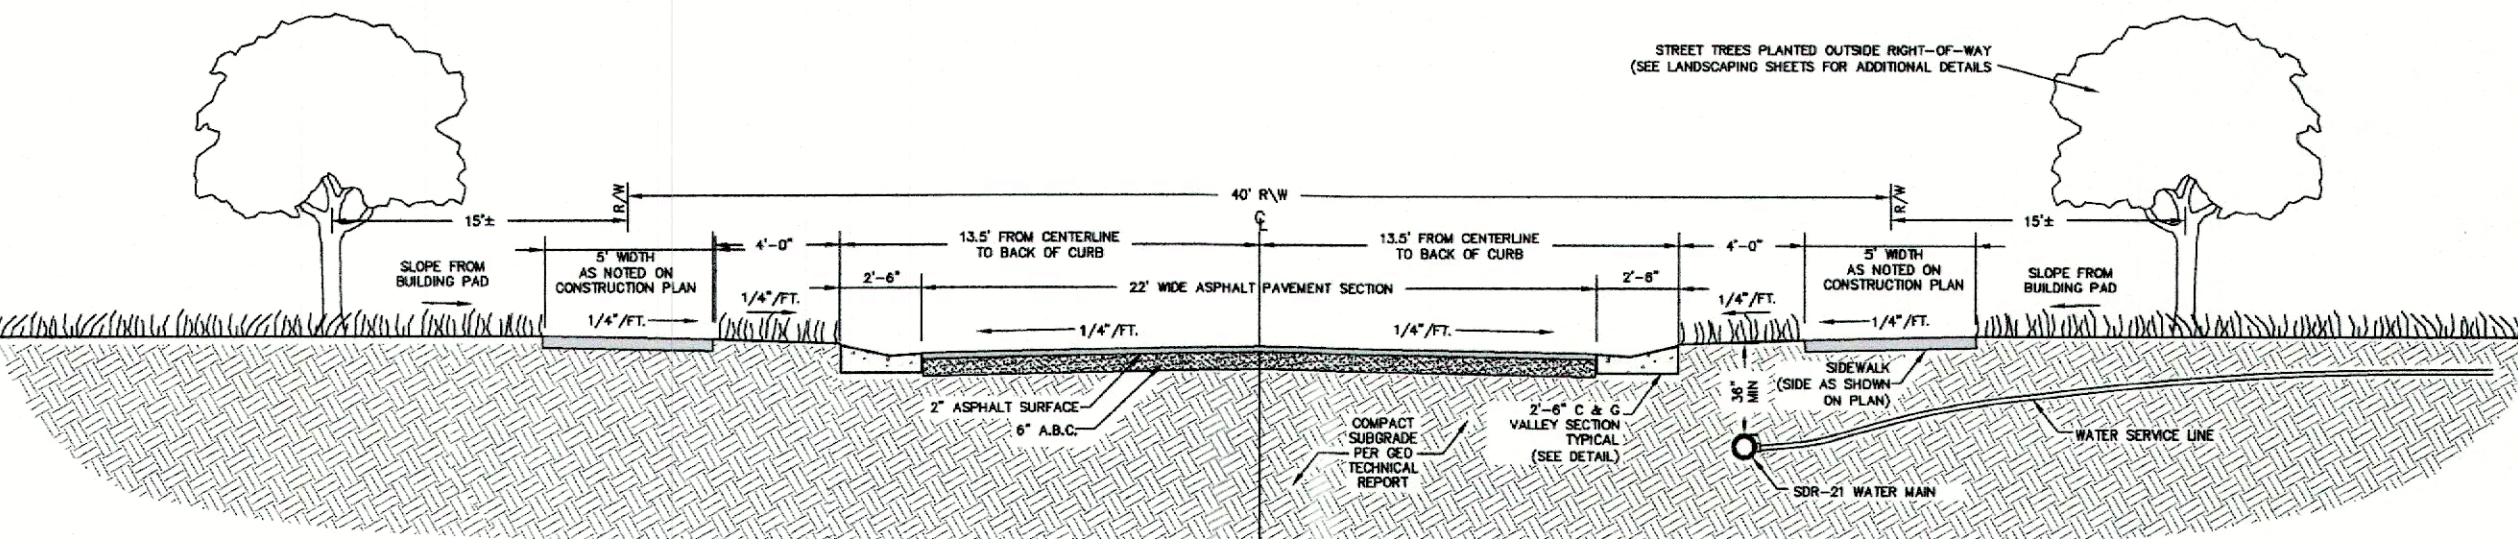

TYPICAL SUBDIVISION ROADWAY SECTION W/ UTILITIES SECTION VIEW NOT TO SCALE

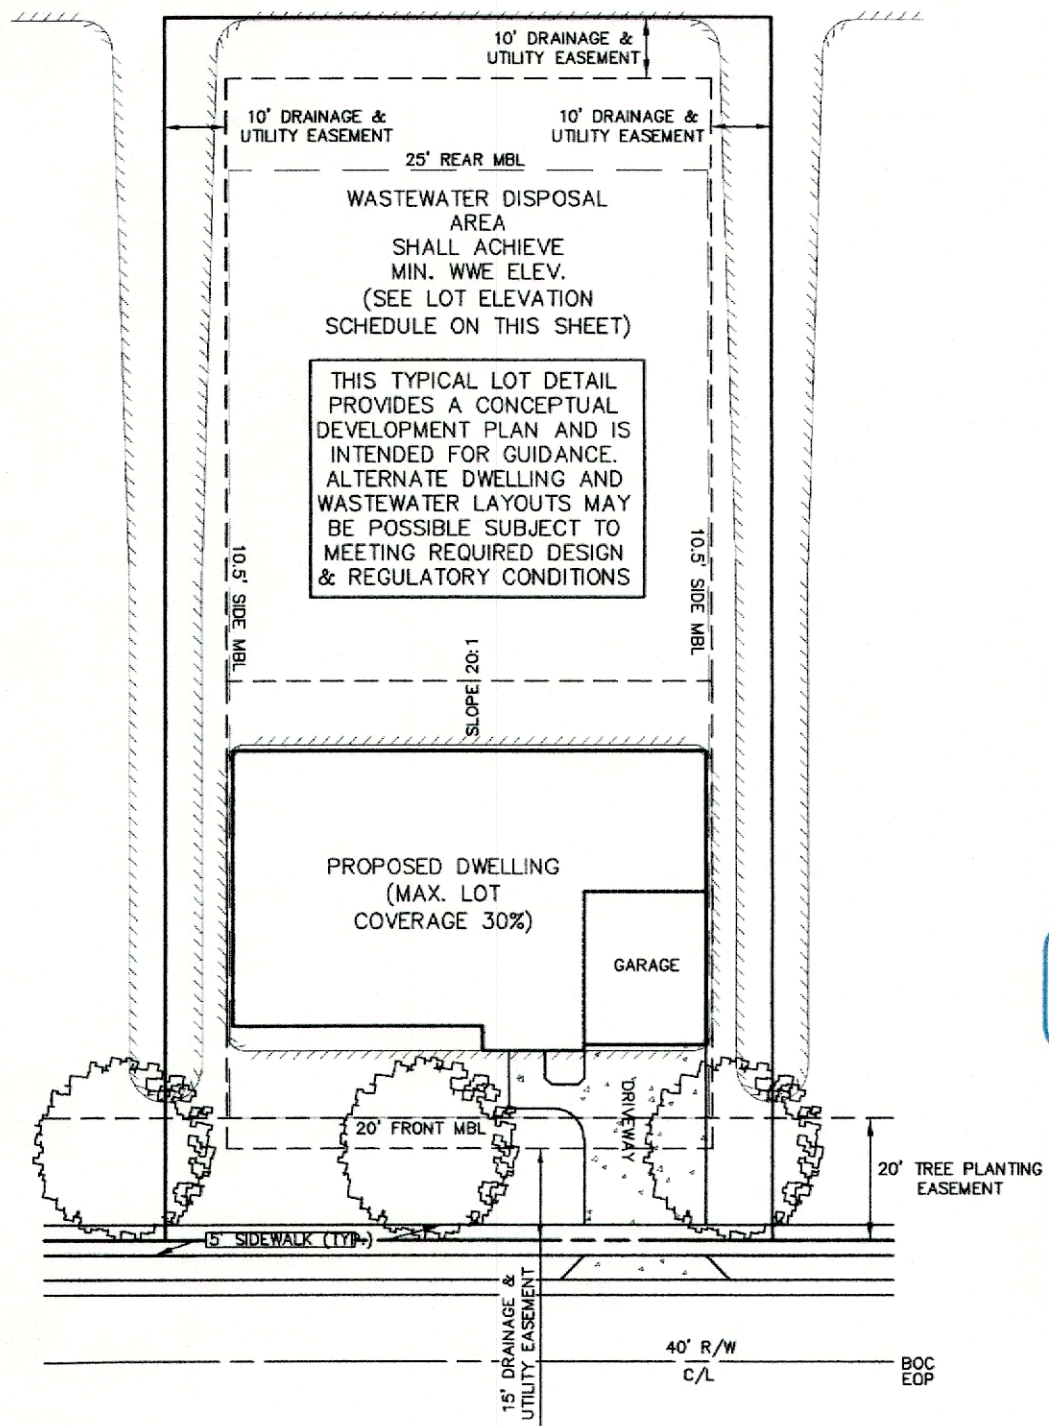

TYPICAL LOT DEVELOPMENT EXHIBIT SCALE: 1"=30' TYP. LOT SIZE = 20,000 SF

S:\projects\4578 Word 274 Acad.dwg\FINAL PLATS\Phase 6\457800FP6.dwg 10/25/2023 10:02 AM HP Desktop T2500 PS HPQ2.pc3

BASSELL PROFESSIONAL GROUP
 Engineers, Planners, Surveyors
 and Environmental Specialists
 202 North Station Highway
 P.O. Box 1085
 Kitty Hawk, North Carolina 27949
 (252) 261-3286
 FAX (252) 261-1760

WATERLEIGH - PHASE 6
 NOTES & DETAILS
 PROJECT: MOYOCK TOWNSHIP CURRITUCK COUNTY NORTH CAROLINA
FINAL CONSERVATION SUBDIVISION PLAN

NO.	DATE	DESCRIPTION	BY

DocuSigned by:
Michael...
 C6DA34EC9CBF428
 SIGNATURE: MICHAEL...
 DATE: 08-15-23
 SCALE: N/A
 DESIGNED: MDB
 DRAWN: AKM
 APPROVED: BPG

SHEET: **7** OF **7**
 CAD FILE: 457800FP6
 PROJECT NO: 4578