


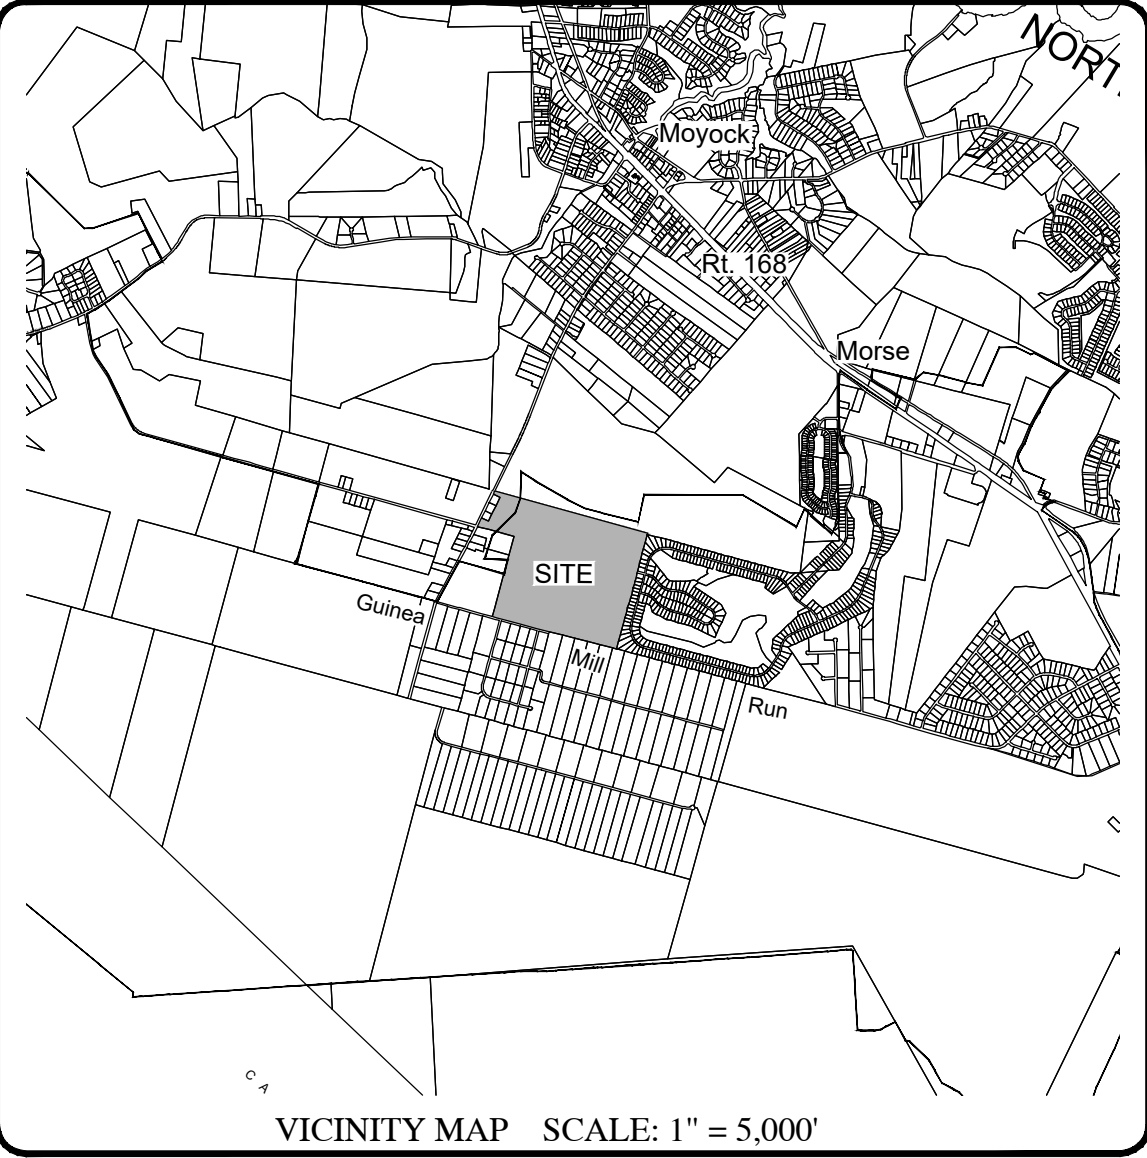

LOTUS RIDGE CONSTRUCTION RECORD

DRAWINGS

PHASE 1

MOYOCK TOWNSHIP CURRITUCK COUNTY NORTH CAROLINA

A 177 LOT SINGLE FAMILY SUBDIVISION

GENERAL NOTES:

- PROJECT NAME: LOTUS RIDGE
- APPLICANT: MOYOCK DEVELOPMENT, LLC
417-D CARATOKE HIGHWAY
MOYOCK, NC 27958
- OWNERS: FPI CAROLINAS, LLC
4600 S. SYRACUSE ST., SUITE 1450
DENVER, CO 80237
- ALL SURVEY DATA IS REFERENCED TO NAD 83 NORTH CAROLINA STATE PLANE HORIZONTAL COORDINATE SYSTEM AND THE NAVD 1988 VERTICAL DATUM.
- F.I.R.M. DATA:
ZONE X PER F.I.R.M. MAP NOS. 3721802000 J & 3721802100 K, BOTH HAVING AN EFFECTIVE DATE DECEMBER 21, 2018. USE OF LAND WITHIN A FLOODWAY OR FLOOD PLAIN IS SUBSTANTIALLY RESTRICTED BY CHAPTER 7 OF THE CURRITUCK COUNTY UNIFIED DEVELOPMENT ORDINANCE.
- THESE CONSTRUCTION RECORD DRAWINGS AREA BASED ON A COMBINATION OF ACTUAL FIELD SURVEYS AND FIELD OBSERVATIONS PERFORMED BY BISSELL PROFESSIONAL GROUP AS WELL AS INFORMATION PROVIDED BY THE PROJECT'S CONSTRUCTION CONTRACTORS AND THE CURRITUCK COUNTY WATER DEPARTMENT. ANY SITE MODIFICATIONS MADE AFTER THE LAST FIELD SURVEY ARE NOT REPRESENTED IN THESE DRAWINGS. CONTRIBUTING FIELD SURVEYS WERE CONDUCTED ON THE FOLLOWING DATES:
 - 06-02-25
 - 06-10-25
 - 06-11-25
 - 06-13-25
 - 06-16-25
 - 06-17-25
 - 07-09-25
 - 07-24-25
 - 07-25-25

PERFORMANCE GUARANTEE
SHOULD THE OWNER OR DEVELOPER FAIL TO COMPLETE INSTALLATION OF THE GUARANTEED IMPROVEMENTS PER APPROVED PLAN WITHIN THE TERM OF THE PERFORMANCE (AS MAY BE EXTENDED), THE DIRECTOR SHALL GIVE THE OWNER OR DEVELOPER 30 DAYS WRITTEN NOTICE OF THE DEFAULT BY CERTIFIED MAIL. AFTER THE 30-DAY NOTICE PERIOD EXPIRES, THE COUNTY MAY DRAW ON THE GUARANTEE AND USE THE FUNDS TO PERFORM WORK NECESSARY TO COMPLETE INSTALLATION OF THE GUARANTEED IMPROVEMENTS. UPON COMPLETION OF SAID WORK, THE COUNTY SHALL PROVIDE AN ACCOUNTING STATEMENT OF THE EXPENDITURES TO THE OWNER OR DEVELOPER AND AS APPLICABLE, THE OWNER OR DEVELOPER SHALL REIMBURSE THE COUNTY IN ORDER TO BE RELEASED OF BOND AND AVOID A WARRANT OF INDEBTEDNESS.

AS-BUILT SURVEY
I HEREBY CERTIFY THAT ALL IMPROVEMENTS FOR THIS SUBDIVISION HAVE BEEN INSTALLED ACCORDING TO THE PLANS PREPARED BY BISSELL PROFESSIONAL GROUP AND APPROVED BY CURRITUCK COUNTY, EXCEPT THAT A PERFORMANCE GUARANTEE HAS BEEN POSTED WITH CURRITUCK COUNTY GUARANTEEING THAT ALL REMAINING IMPROVEMENTS MUST BE COMPLETED BY THE 31ST DAY OF MARCH, 2027 ACCORDING TO THE PLANS AND SPECIFICATIONS PREPARED BY BISSELL PROFESSIONAL GROUP. FINAL GROUND STABILIZATION OF THE SITE IS ONGOING AND IS NOT INCLUDED IN THIS CERTIFICATION.
REMAINING IMPROVEMENTS INCLUDE:

- SIDEWALKS AND MULTI-USE PATH
- STREET TREES
- FLORA PORTION OF ROWLAND CREEK IMPROVEMENTS
- PERMANENT STREET SIGNS AND TRAFFIC CONTROL SIGNS
- PAVEMENT MARKINGS
- AQUATIC PLANTINGS FOR STORMWATER BASINS

DATE _____ REGISTERED LAND SURVEYOR/ENGINEER _____
REGISTRATION NUMBER _____

Sheet
Number

Sheet Title

1

COVER SHEET, DEVELOPMENT NOTES & SITE LOCATION

2

DEVELOPMENT OVERVIEW & PHASING PLAN

3

ROADWAY, DRAINAGE & STORMWATER MANAGEMENT PLAN

4

ROADWAY, DRAINAGE & STORMWATER MANAGEMENT PLAN

5

POTABLE WATER MAIN & WATER SERVICES PLAN

6

POTABLE WATER MAIN & WATER SERVICES PLAN

7

PHASE 2 WATER MAIN CONNECTION & STORMWATER DRAINAGE

LEGEND	
---	ROADWAY CENTERLINE
---	RIGHT-OF-WAY
---	PROPERTY BOUNDARY
---	ADJOINING PROPERTY LINE
---	SWALE CENTERLINE
---	SWALE/BMP TOP OF BANK
---	CULVERT (SIZE, TYPE & INVERTS AS NOTED)
---	RECORD WATER DISTRIBUTION MAIN (SIZE AS NOTED)
---	EXISTING WATER LINE
EWL	6" FIRE HYDRANT TYPICAL
WV	WATER VALVE TYPICAL (SIZE AS NOTED)
MSB	WATER SERVICE METER BOX
S	8" GRAVITY SEWER LINE & MANHOLE
D	CATCH BASIN/DROP INLET & STORM PIPE
SC	SEWER SERVICE CLEANOUT
DFD	DRAINAGE FLOW DIRECTION
FL	FLOWLINE
EOC	EDGE OF CONCRETE
X 0.00	BUILDING PAD ELEVATION
BPE	SPOT ELEVATION
X 0.00	

Bissell Professional Group
Firm License # C-245
P.O. Box 1159
Kitty Hawk, North Carolina 27949
FAX (252) 281-1760

BISSELL
PROFESSIONAL GROUP
Engineers, Planners, Surveyors
and Environmental Specialists

COVER SHEET, DEVELOPMENT
NOTES & SITE LOCATION

THIS DOCUMENT IS THE SOLE PROPERTY OF BPG, INC. OF KITT
PART OF THE MODIFICATION OF ANY DETAIL OR DESIGN IS NOT TO
BE MADE WITHOUT THE EXPRESS WRITTEN CONSENT OF MARK S
BISSELL, PRINCIPAL OF BPG, INC. COPYRIGHT 2005.


PROJECT: LOTUS RIDGE NORTH CAROLINA
MOYOCK TOWNSHIP CURRITUCK COUNTY
PRELIMINARY LAND DEVELOPMENT PLAN

REVISIONS	
NO.	DATE

PRELIMINARY
DO NOT USE FOR
CONSTRUCTION

DATE:	7/15/25	SCALE:	N/A
DESIGNED:	BPG	CHECKED:	MSB
DRAWN:	KFW	APPROVED:	BPG
SHEET:	1	OF	7
CAD FILE:	47840ASB1		
PROJECT NO:	4784		

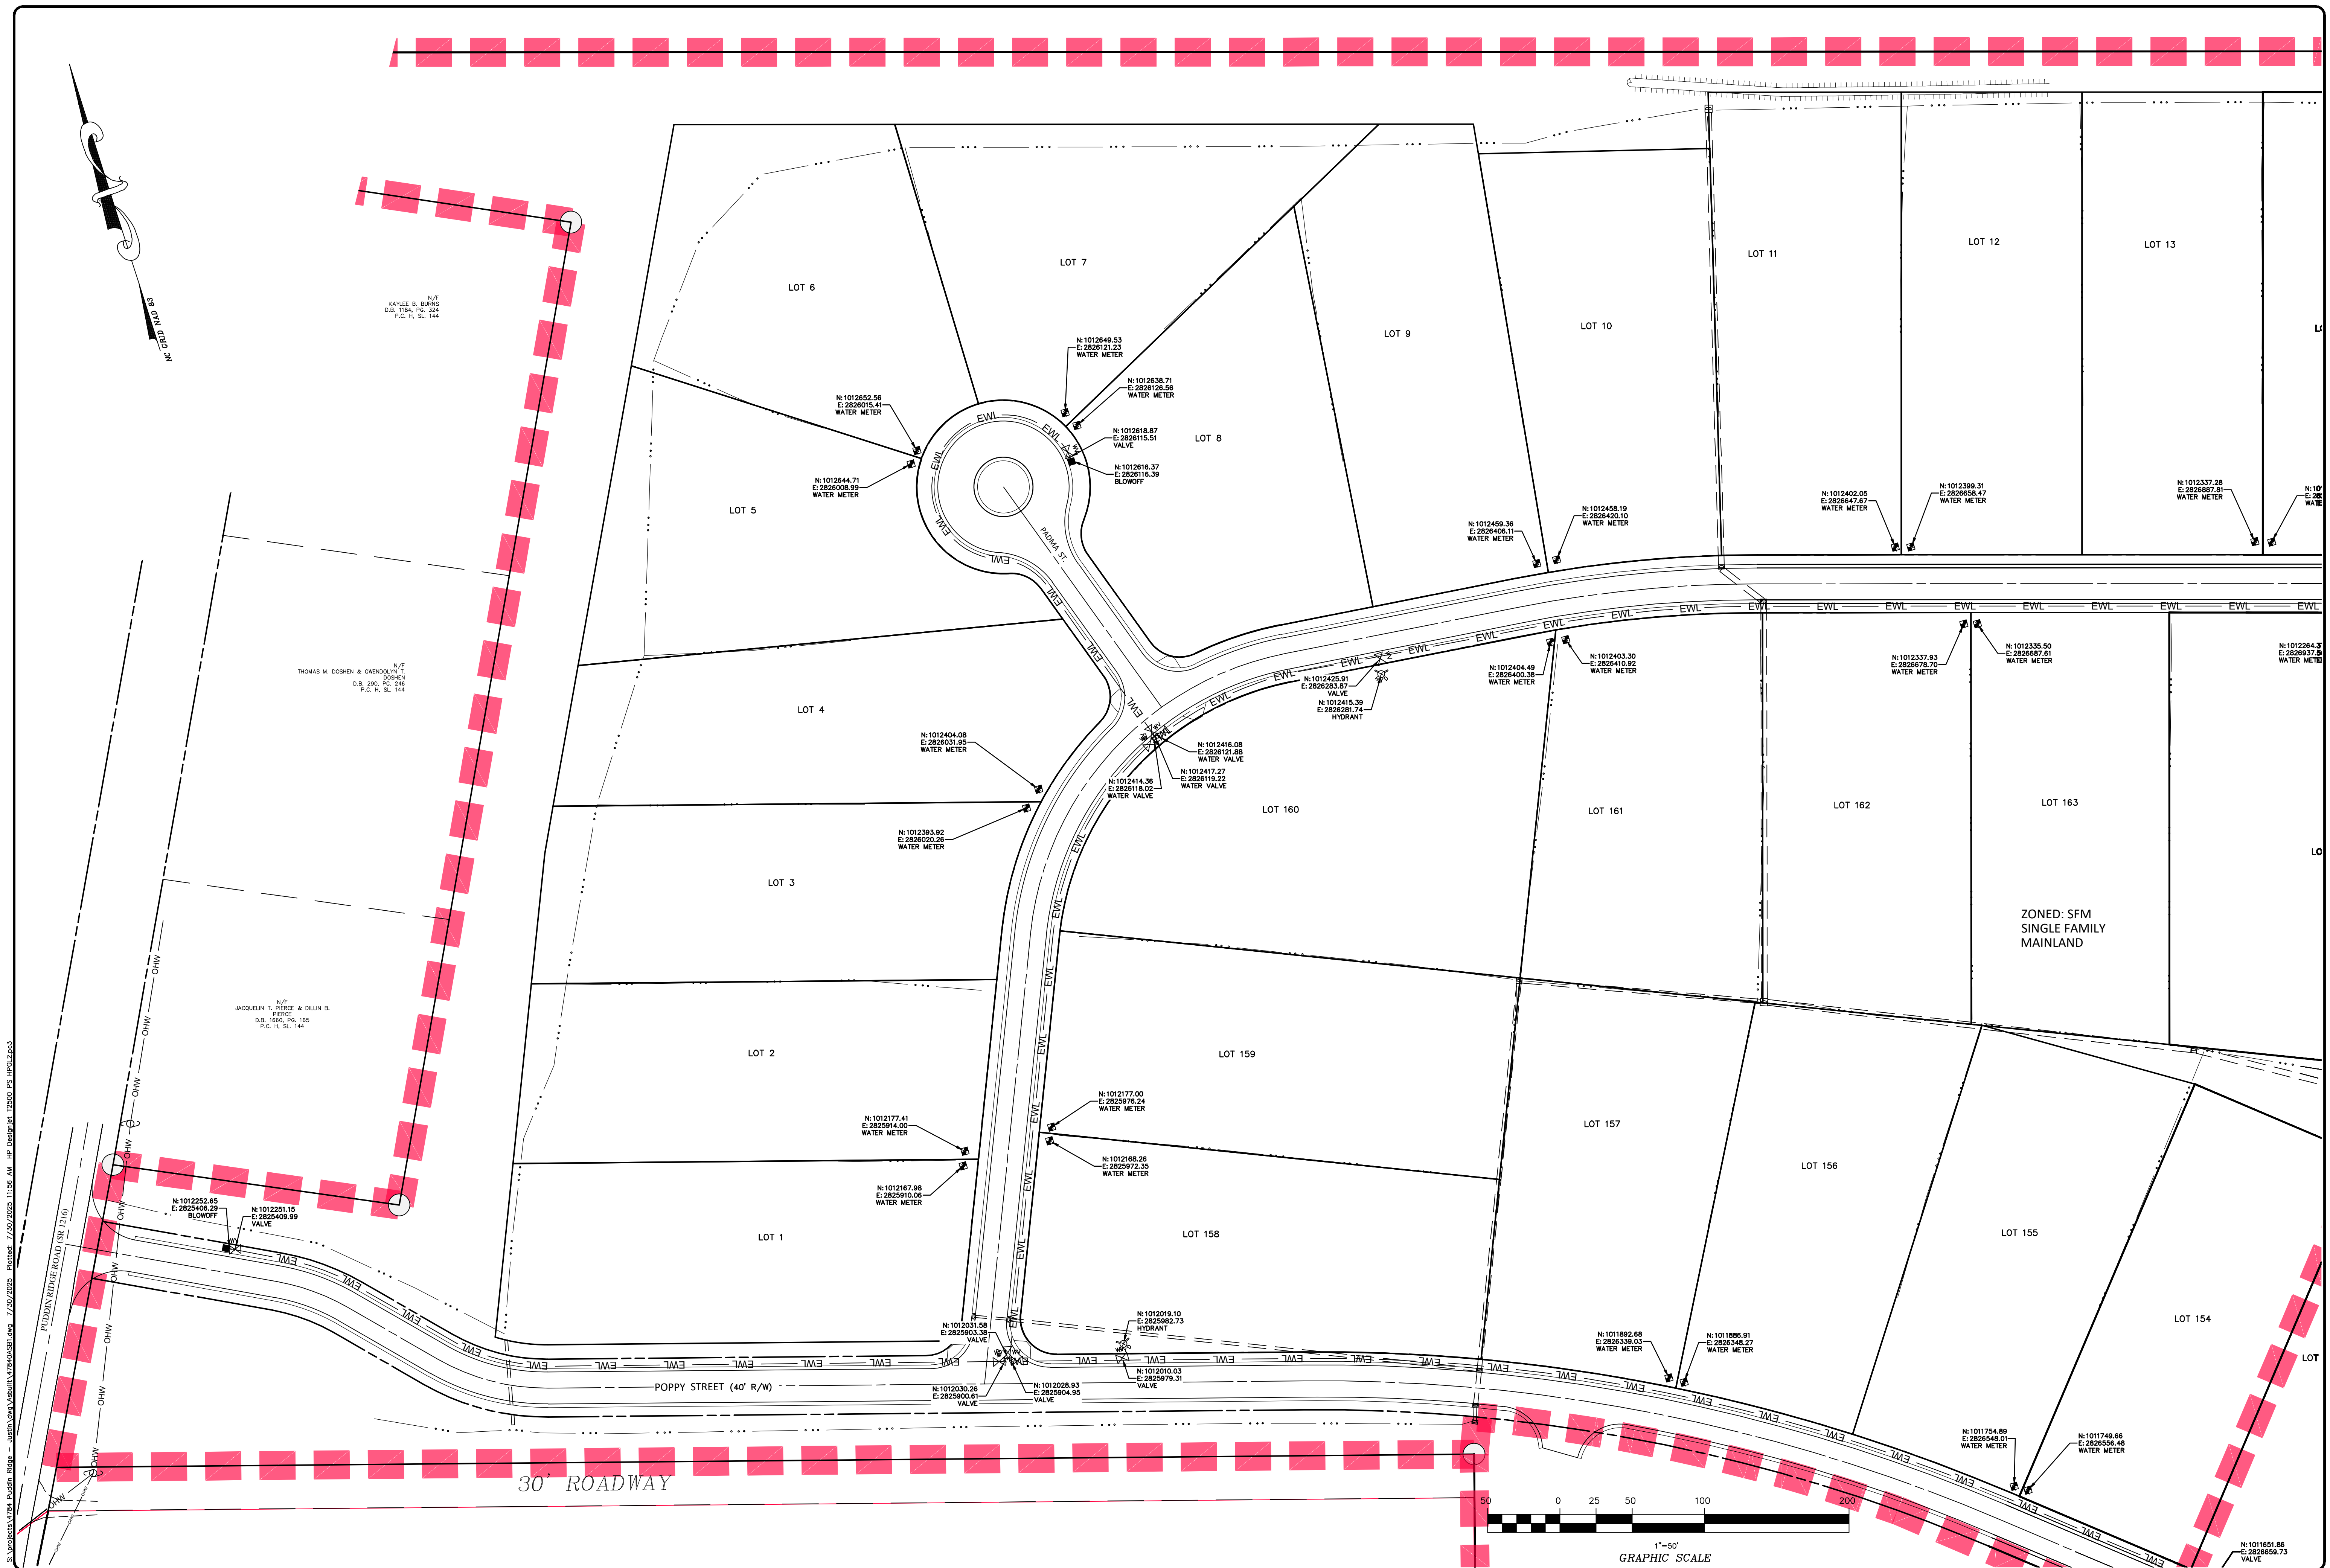

[illegible]

STORMWATER STATEMENT
NO MORE THAN 30% OF ANY LOT SHALL BE COVERED BY IMPERVIOUS STRUCTURES AND MATERIALS, INCLUDING ASPHALT, GRAVEL, CONCRETE, BRICK STONE, SLATE, OR SIMILAR MATERIAL, NOT INCLUDING WOOD DECKING OR THE WATER SURFACE OF SWIMMING POOLS. THIS COVENANT IS INTENDED TO ENSURE COMPLIANCE WITH THE STORMWATER PERMIT NUMBER _____ ISSUED BY THE STATE OF NORTH CAROLINA. THE COVENANT MAY NOT BE CHANGED OR DELETED WITHOUT THE CONSENT OF THE STATE. FILLING IN OR PIPING OF ANY VEGETATIVE CONVEYANCES (DITCHES, SWALES, ETC.) ASSOCIATED WITH THIS DEVELOPMENT, EXCEPT FOR AVERAGE DRIVEWAY CROSSINGS, IS STRICTLY PROHIBITED BY ANY PERSON. THE LOT COVERAGE ALLOWANCE PROVIDED IN THE CURRITUCK COUNTY UNIFIED DEVELOPMENT ORDINANCE MAY BE DIFFERENT THAN THE NC STATE STORMWATER PERMIT. THE MOST RESTRICTIVE LOT COVERAGE SHALL APPLY.

I HEREBY CERTIFY THAT THE PUBLIC STREETS SHOWN ON THIS PLAT ARE INTENDED FOR DEDICATION AND HAVE BEEN DESIGNED OR COMPLETED IN ACCORDANCE WITH AT LEAST THE MINIMUM SPECIFICATIONS AND STANDARDS OF THE NC DEPARTMENT OF TRANSPORTATION FOR ACCEPTANCE OF SUBDIVISION STREETS ON THE NC HIGHWAY SYSTEM FOR MAINTENANCE.



APPROVAL CERTIFICATE
I HEREBY CERTIFY THAT THE SUBDIVISION SHOWN ON THIS PLAT IS IN ALL
RESPECTS IN COMPLIANCE WITH THE CURRITUCK COUNTY UNIFIED DEVELOPMENT
ORDINANCE AND, THEREFORE, THIS PLAT HAS BEEN APPROVED BY THE CURRITUCK
COUNTY TECHNICAL REVIEW COMMITTEE AND SIGNED BY THE ADMINISTRATOR,
SUBJECT TO ITS BEING RECORDED IN THE CURRITUCK COUNTY REGISTRY WITHIN 90
DAYS OF THE DATE BELOW.

LOT AREAS: VARY FROM 40,000 TO 57745 SQUARE FEET.
MINIMUM LOT WIDTH (CORNER OR INTERIOR LOTS): 125'.

A PAYMENT IN LIEU OF RECREATION AND PARK AREA DEDICATION HAS BEEN PROVIDED IN ACCORDANCE WITH THE CURRITUCK COUNTY UNIFIED DEVELOPMENT ORDINANCE. PAYMENT IN LIEU RECEIVED BY THE COUNTY SHALL BE USED ONLY FOR THE ACQUISITION AND DEVELOPMENT OF RECREATION AND PARK AREAS, AND OPEN SPACE SITES CONSISTENT WITH THE REQUIREMENTS OF NORTH CAROLINA GENERAL STATUTES SECTION 153A-331.

DATE _____ REVIEW OFFICER _____

4784

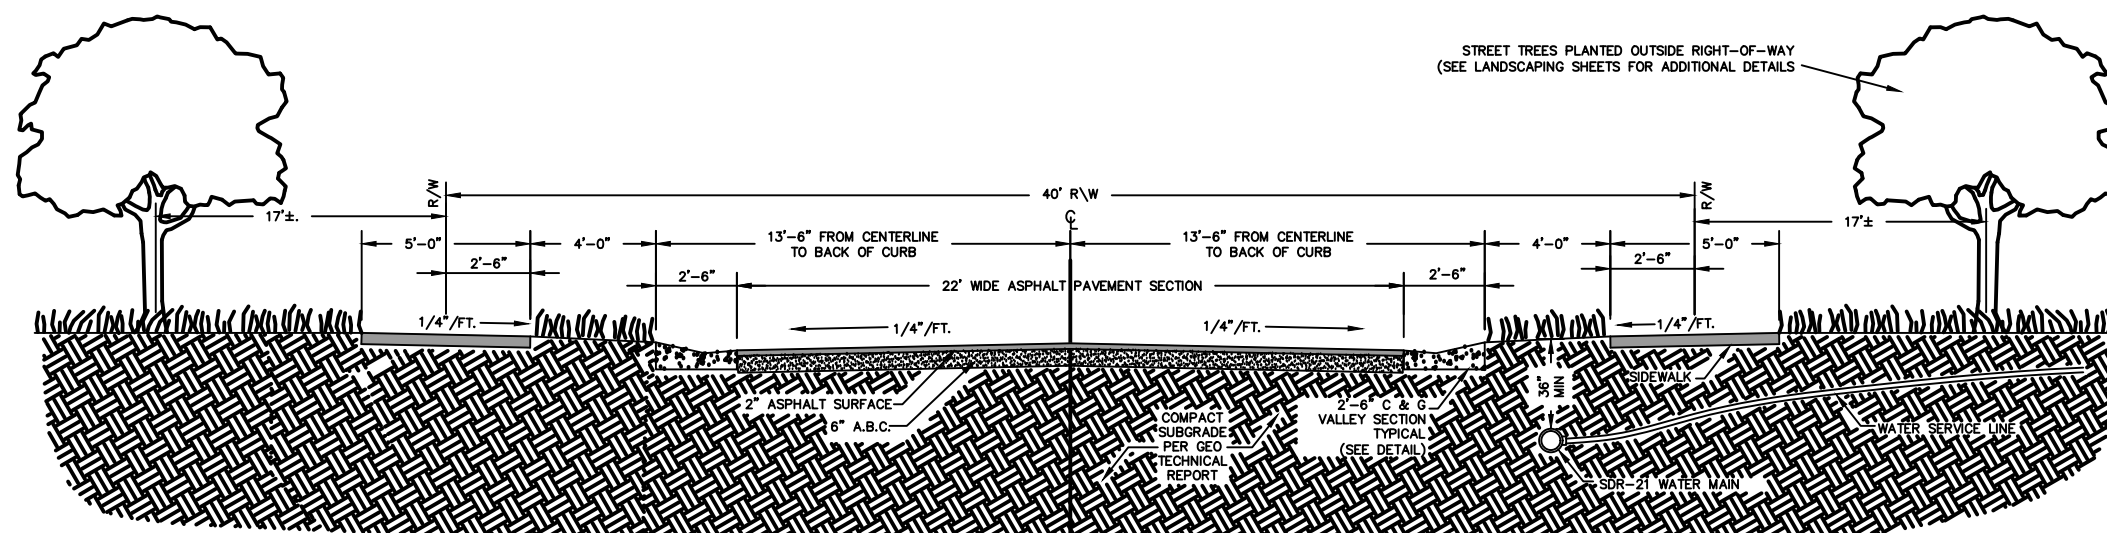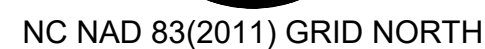

400 0 200 400 800 1600

1" = 400'

GRAPHIC SCALE

DATE: 07-04-25		SCALE: 1" = 400'	
DESIGNED:		CHECKED:	
		MSB	
DRAWN:		APPROVED:	
MDB		BPG	
SHEET:			
2		OF 5	
CAD FILE: 478400FP1			
PROJECT NO: 4784			



PROJECT: **LOTUS RIDGE**
PHASE 1

MOYOCK TOWNSHIP CURRITUCK COUNTY NORTH CAROLINA

FINAL SUBDIVISION PLAT

[illegible]

DATE: 07-04-25	SCALE: 1"=100'
DESIGNED:	CHECKED: MSB
DRAWN: MDB	APPROVED: BPG

SHEET:

3 OF 5


CAD FILE:
478400FP1

PROJECT NO:

4784



Bissell Professional Group
Firm License # C-956
3512 North Oration Highway
P.O. Box 1068
(252) 261-3266
(252) 261-3766
FAX (252) 261-1760

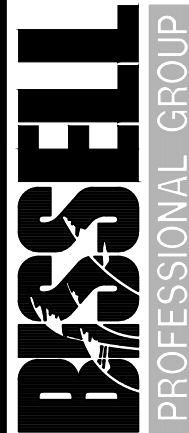

**Engineers, Planners, Surveyors
and Environmental Specialists**

PROJECT: **LOTUS RIDGE**
PHASE 1

MOYOCK TOWNSHIP **CURRITUCK COUNTY** **NORTH CAROLINA**

FINAL SUBDIVISION PLAT

[illegible]

DATE: 07-04-25	SCALE: 1"=100'
DESIGNED:	CHECKED: MSB
DRAWN: MDB	APPROVED: BPG

SHEET:
4 OF 5
CAD FILE:
478400FP1
PROJECT NO:
4784

LOTUS RIDGE
PHASE 1

MOYOCK TOWNSHIP **CURRITUCK COUNTY** **NORTH CAROLINA**

PROJECT:

FINAL SUBDIVISION PLAT

LOTUS RIDGE
PHASE 1

MOYOCK TOWNSHIP **CURRITUCK COUNTY** **NORTH CAROLINA**

PROJECT:

FINAL SUBDIVISION PLAT

